


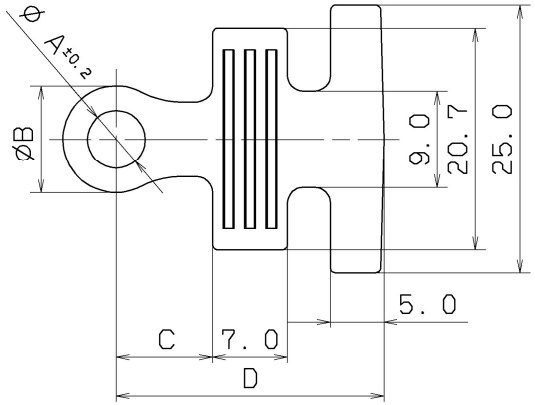


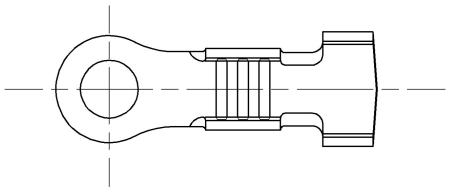

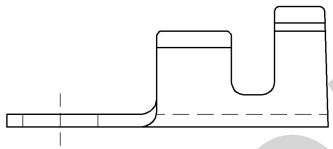

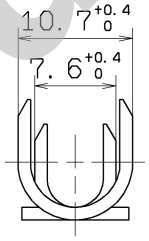

PART NO.	③ NOMINAL DESIGNATION OF JIS	APPLICABLE SCREW SIZE	A	B	C	D	④ TREATMENT
7009-1350	LA405	5	5.4	10	9	25	———
-1351	406	6	6.4	12	10	26	———
-1352	408	8	8.4	16	12	28	———
-1353	410	10	10.4	20	14	30	———
③① ~~-1354~~		~~12~~	~~12.6~~	~~24~~	~~16~~	~~32~~	
③① ~~-1355~~		~~14~~	~~14.7~~	~~24~~	~~16~~	~~32~~	
7009-1350-02	LA405	5	5.4	10	9	25	Sn-PLATING
-1351-02	406	6	6.4	12	10	26	Sn-PLATING
-1352-02	408	8	8.4	16	12	28	Sn-PLATING
-1353-02	410	10	10.4	20	14	30	Sn-PLATING

NOTE

② 1) APPLICABLE WIRE SIZE: 3+3~15mm²

Confidential

LET	DATE	REVISION RECORD	NO.	CHKD
④	13. 06. 19	ADDED TREATMENT & RENEW	C13-3730	G. S
③	10. 03. 16	DELETED PART NO., ADDED SPEC & RENEW	C10-3296	J. C
②	04. 06. 25	CHANGED WIRE SIZE	C04-4385	J. V
①	99. 03. 15	ADDED PART NO.	C99-3254	Y. K
	93. 12. 07	NEW	C93-4189	Y. K

GENERAL TOLERANCE						
	10MAX	50MAX	100MAX	250MAX	250OVR	ANGLE	ECCENT
A	±0. 15	±0. 2	±0. 3	±0. 5	±0. 75	±30'	0. 1
B	±0. 2	±0. 3	±0. 55	±0. 95	±1. 4	±30'	0. 1
Ⓒ	±0. 3	±0. 5	±0. 8	±1. 4	±2	±30'	0. 15

SPECIFIED

MASS g

CUSTOMER	
CUSTOMER PART NO.	CUSTOMER DWG NO.
OFFICE	TRIAL PART NO.
VENDOR	
VENDOR NO.	

DWG TYPE	DWG SOURCE	DWG DATE	UNIT	SCL	ANGLE
R	NEW	93. 12. 07	mm	2/1	3

APPROVED	CHECKED	CHECKED	DESIGN	DRAWN
寺田	関野	岡本	ISHIZUKA	G. SABATER
			70. 04. 09	13. 06. 19

ISSUE MARK

MATL. SPEC.	BRASS t=1. 18
TREAT. & FIN.	SEE TABLE
NAME	LA TERMINAL
PART NO. CH. CODE	7009-1350 ETC.
DWG NO.	7009-1350:R
SET DWG NO.	

YAZAKI CORPORATION

20130619-73461